




AS-BUILT
AVAILABLE
MAY 8, 2023

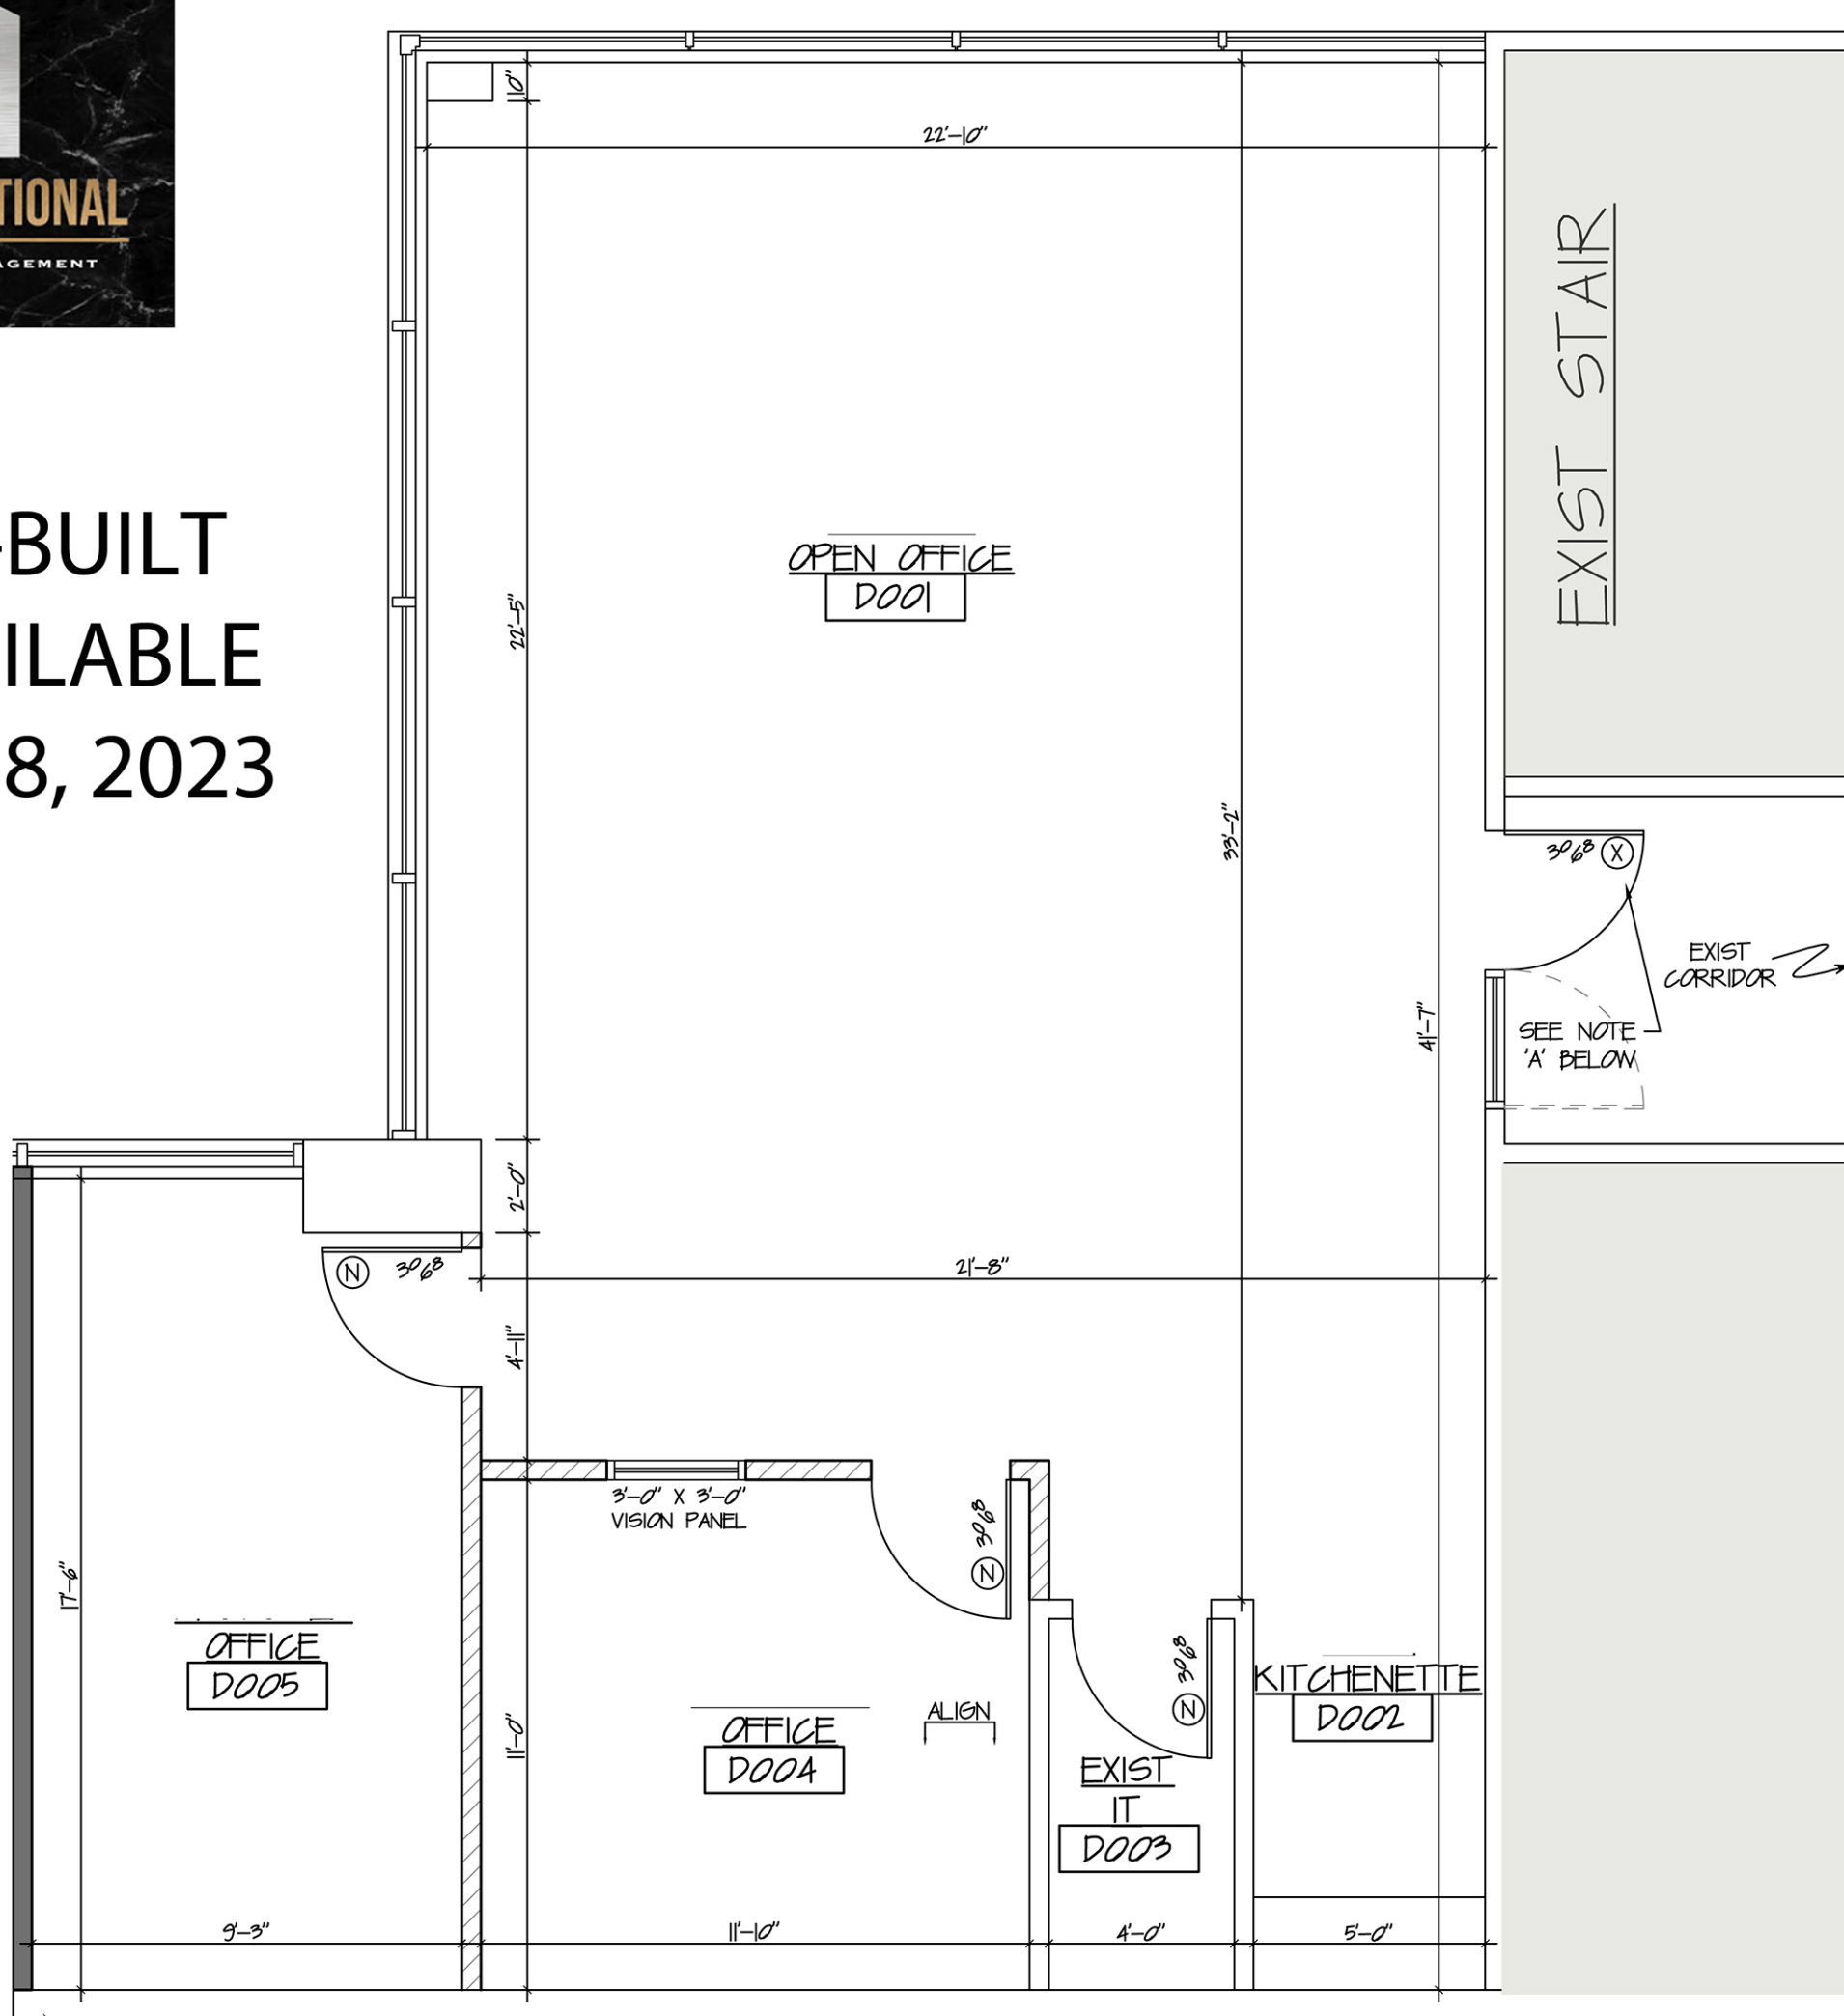

FNCUSA.COM
lease@fncusa.com